



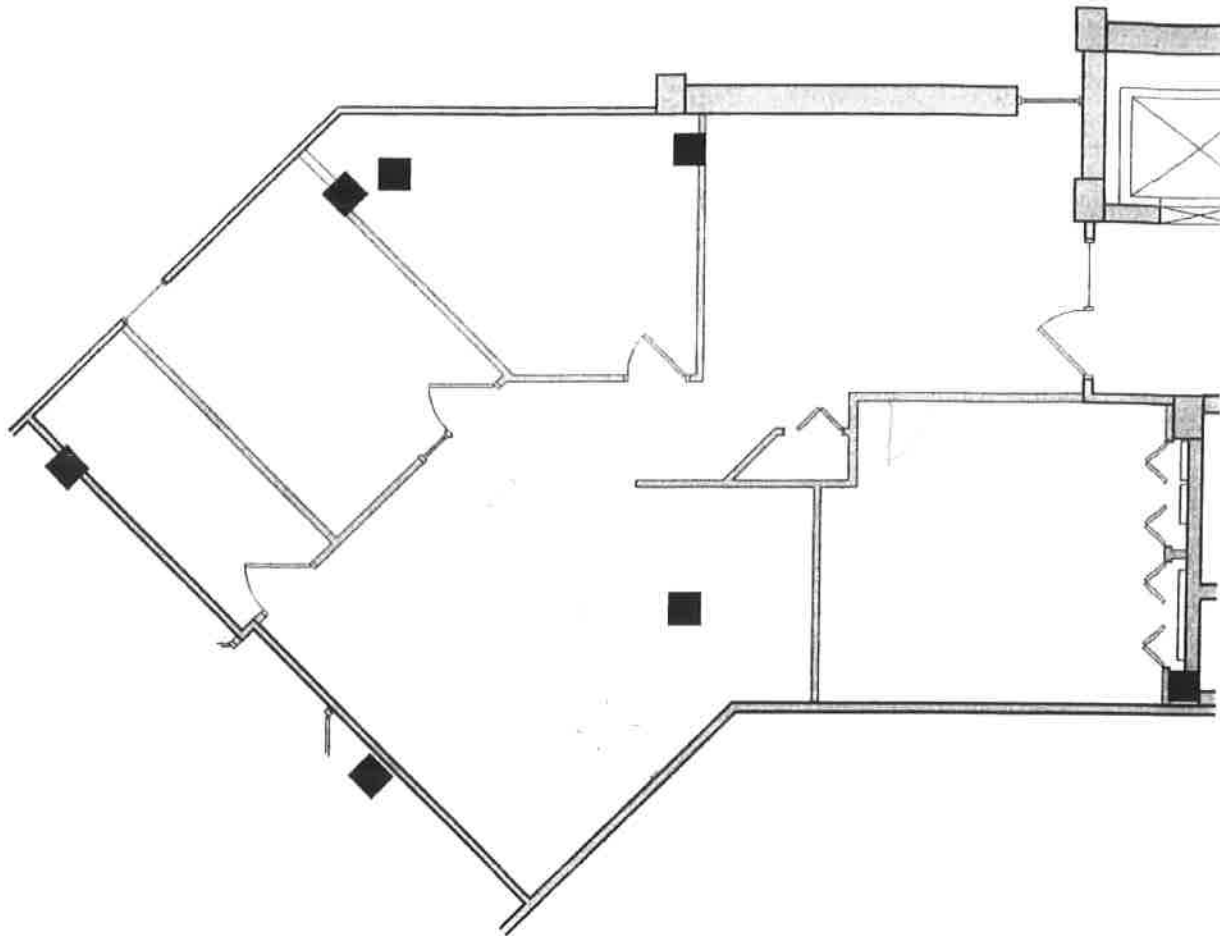

BUILDING KEY

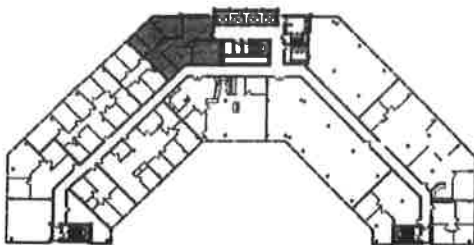

GENESIS

ARCHITECTURE

A WELSH COMPANY

7807 Creekridge Circle
Minneapolis, MN 55439
952.897.7874 Fax: 952.897.7740

AS-BUILT FLOOR PLAN
SUITE 901
1,432 RSF.
SOUTHGATE OFFICE PLAZA
5001 AMERICAN BLVD.
BLOOMINGTON, MN

SCALE: AS NOTED
JOB: 2002.068.0
REVISION: DATE
XXX

DRAWN BY: JLN
DATE: 01 MAR 06

A-1