



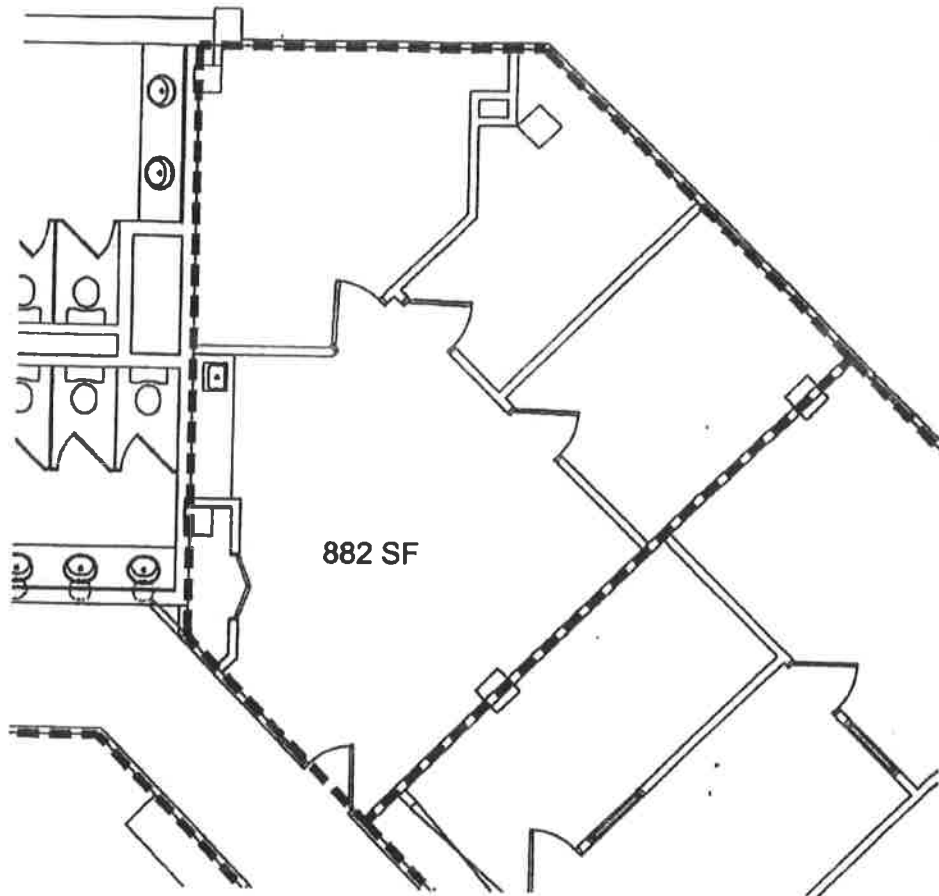

N   FLOOR PLAN
1/8" = 1'-0"

THIS PLAN IS
AN AS-BUILT
DOCUMENT TO
BE USED TO
DOCUMENT THE
EXISTING SPACE.
THIS DOCUMENT
DOES NOT
DETERMINE
SPACES
COMPLIANCE
WITH EXISTING
BUILDING CODES.

BUILDING KEY

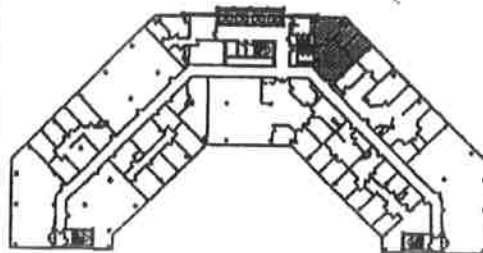

NOT TO SCALE

GENESIS

ARCHITECTURE
A WELSH COMPANY

7801 Crossbridge Circle
Minneapolis, MN 55439
952.897.7874 Fax: 952.897.7740

AS-BUILT FLOOR PLAN
SUITE 605
SOUTHGATE OFFICE PLAZA
5001 W. 80TH ST.
BLOOMINGTON, MN

SCALE: AS NOTED
JOB: 2002.0630
REVISION: DATE
 XXX

DRAWN BY: MRL
DATE: 06.27.02

A-1