


THIS PLAN IS AN  
AS-BUILT DOCUMENT  
TO BE USED TO  
DOCUMENT THE  
EXISTING SPACE.  
THIS DOCUMENT  
DOES NOT  
DETERMINE SPACES  
COMPLIANCE WITH  
EXISTING BUILDING  
CODES.

#### BUILDING KEY

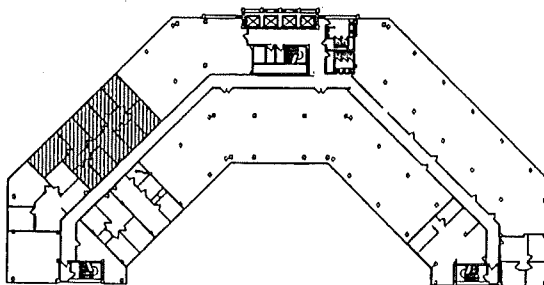

NOT TO SCALE

**GENESIS**

ARCHITECTURE

A WELSH COMPANY

7807 Creekridge Circle  
Minneapolis, MN 55439  
952.897.7874 Fax: 952.897.7740

AS-BUILT FLOOR PLAN

SUITE 915  
SOUTHGATE OFFICE PLAZA  
5001 W. 80TH ST.  
BLOOMINGTON, MN

SCALE:

JOB:

REVISION:



AS NOTED

2002.068.0

DATE

XXX

DRAWN BY: LAW

DATE: 07.09.02

**A-1**